

# Water Supply and Sewage Disposal IMPROVEMENTS PERMIT

SPRING  
CITY

Lot  
Block  
Map

No. 11090

Date 7-9-96

Owner: \_\_\_\_\_

Location: 1950 1/2 (R) RUSSELL BLVD  
1570 HOME OWN

Contractor: \_\_\_\_\_

Water Supply: Private  Public \_\_\_\_\_

No. Bedrooms 2 Other \_\_\_\_\_

Daily Flow Rate \_\_\_\_\_ Application Rate \_\_\_\_\_

REINSPECTION TO ADD 5th ROOM  
SCARRED PORCH & DECK

Size of tank: \_\_\_\_\_ Nitrification line: SYSTEM

APPEARED TO FUNCTIONING PROPERLY  
AT TIME OF INSPECTION

Water supply and sewage disposal facilities location, installation and protection must meet state and local regulations.

Septic tank should be pumped out every 3 to 5 years and shall be maintained by owner in such a manner as not to create a public health hazard. Septic tank and nitrification line **MUST BE INSPECTED AND APPROVED BY A MEMBER OF THE HEALTH DEPARTMENT STAFF BEFORE ANY PORTION OF THE INSTALLATION IS COVERED AND PUT INTO USE.**

ORIG PERMIT

Signed \_\_\_\_\_  
Sanitarian

UNDER

TAZALAH

Counter-  
signed \_\_\_\_\_  
(Owner or his representative)

This permit is subject to revocation if site plans or the intended use change. This permit for sewage disposal is valid for 5 years.

### Certificate of Completion

Date Approved: 7-9-96 By: [Signature]  
Sanitarian


(OVER)

Location of well and sewage disposal facilities sketched on back.



NOTE: Make sketch of installation showing lot size and shape, location of house, septic tanks, privies, water supplies, etc. Note special problems existing on lot. Write in measurements in order that installations may be located at later date. Note location of water supplies on adjacent lots.

(1)

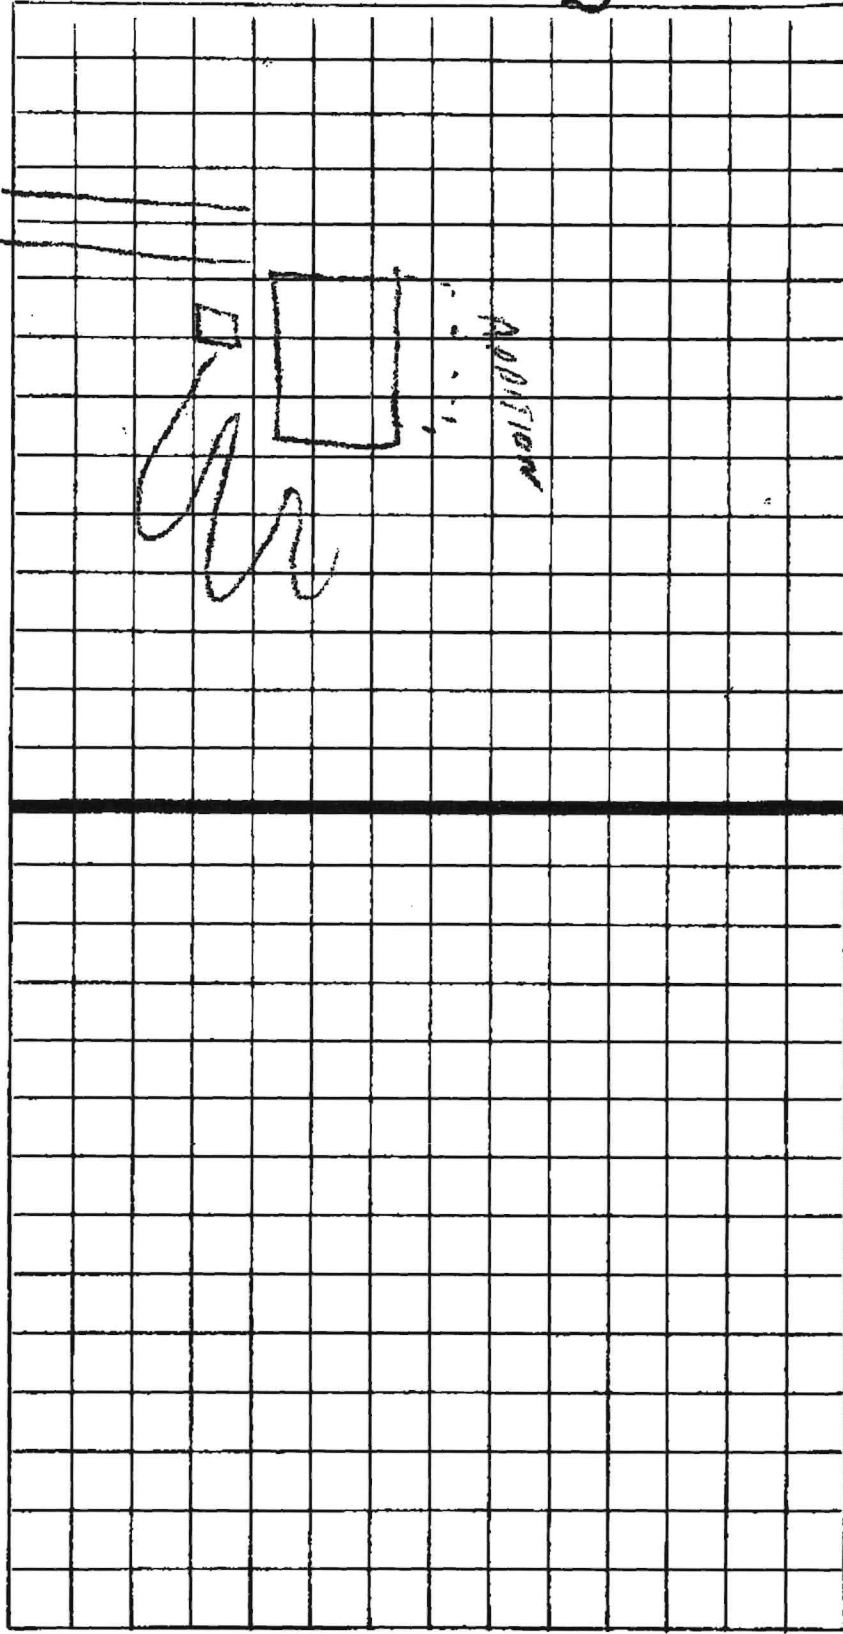

(2)

# Water Supply and Sewage Disposal IMPROVEMENTS PERMIT

No. LC.30  
 Date 10-30-91  
 Owner: JOHN FAZELAAR  
 Location: Across from Northwood School  
Will be used as a septic tank for the ground  
on tonight. Please note 800 ft down for night  
Contract: before now banks by left.  
 Water Supply: Private Existing Public   
 No. Bedrooms 3 Other \_\_\_\_\_  
 Daily Flow Rate 360 Application Rate 0.3

Size of tank: 1000 Nitrification line: 400' X 3' X 34"

Water supply and sewage disposal facilities location, installation and protection must meet state and local regulations. Septic tank should be pumped out every 3 to 5 years and shall be maintained by owner in such a manner as not to create a public health hazard. Septic tank and nitrification line MUST BE INSPECTED AND APPROVED BY A MEMBER OF THE HEALTH DEPARTMENT STAFF BEFORE ANY PORTION OF THE INSTALLATION IS COVERED AND PUT INTO USE.


Signed Jerry D. Collins Sanitarian  
 Counter-signed \_\_\_\_\_ (Owner or his representative)

This permit is subject to revocation if site plans or the intended use change. This permit for sewage disposal is valid for 5 years.

Certificate of Completion  
 Date Approved: 12/20/91 By: James Jones Sanitarian

Location of well and sewage disposal facilities sketched on back. (OVER)

Make sketch of installation showing lot size and shape, location of house, septic tanks, privies, water supplies, etc. Note special problems existing on lot. Write in measurements in order that installations may be located at later date. Note location of water supplies on adjacent lots.

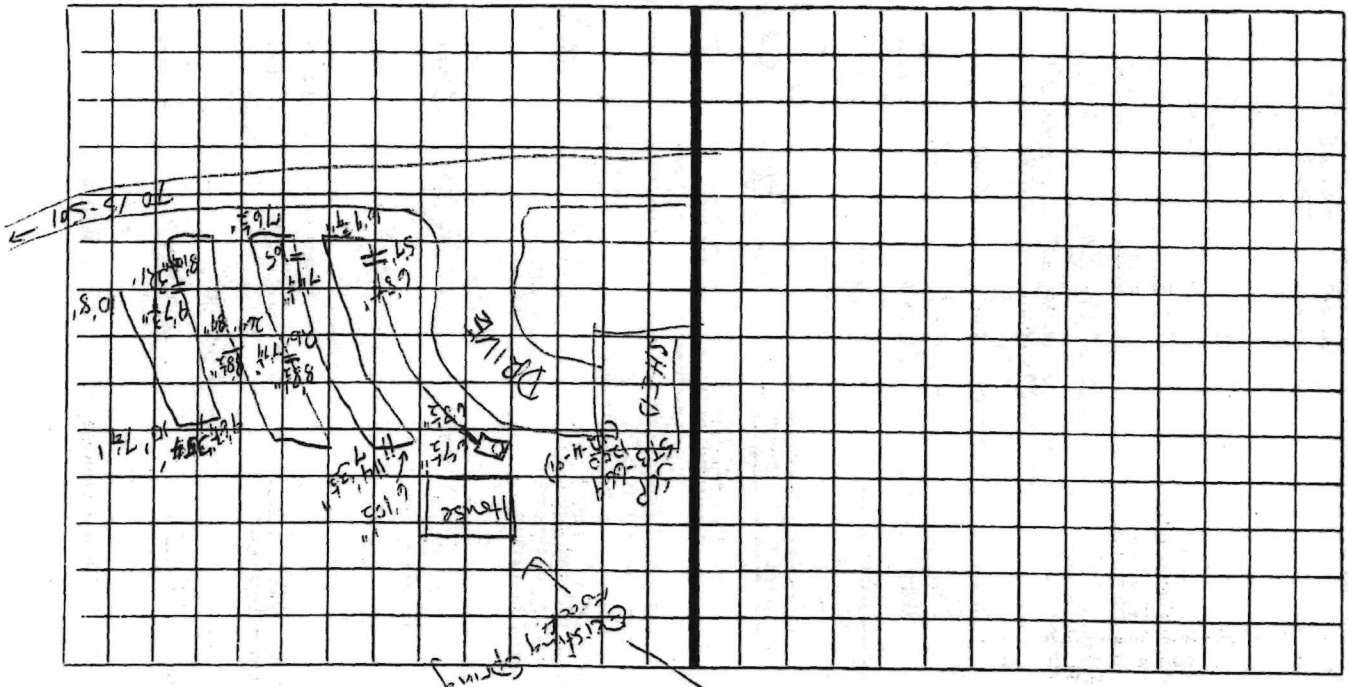

(1) (2)